



22 August 2023

ADDENDUM #02

PROJECT: Perryville Branch Library Renovation

The following items represent changes, modifications and/or clarifications to the Contract Documents for this project. This Addendum shall become a part of the Contract Documents and all Bidders shall acknowledge its inclusion in their bid.

This Addendum consists of the following:

- 2 Typed page (Addendum revisions)
- 1 Drawing Sheet E101B (Addendum revisions)

Responses to Bidder Questions:

1. **Question:** Is this project to be phased?

Answer: The project will not be phased. The library will be closed to the public during construction, and the Contractor will have full access to all project spaces upon the start of construction.

2. **Question:** Is security in the scope? If so, please provide specs for security.

Answer: Security cameras and Card Access Controls will be provided and installed under separate contract by the Owner's Vendor. The pathways, data cabling, and power to support the security system equipment as indicated on Sheet E101B shall be provided under this contract.

3. **Question:** Is low-voltage in the scope? If so, please provide the specs for low voltage.

Answer: The pathways and cabling to support the Telecommunications and Audio-Visual Systems as indicated on Sheet E101A shall be provided under this contract. Refer to sheet E501 for additional low-voltage specifications.

4. **Question:** Are there any preferred vendors, or a do not use list?

Answer: There are no preferred vendors.

5. **Question:** Are there any MBE/VSBE requirements?

Answer: There are no requirements for MBE/VSBE participation.

6. **Question:** Who is responsible for dumpsters?

Answer: Refer to Specification Section 015000 – Temporary Facilities and Controls.

7. **Question:** Are there contractor accessible restrooms?

Answer: Refer to Specification Section 015000 – Temporary Facilities and Controls.

8. **Question:** Are there any parking restrictions? Where are contractors allowed to park?

Answer: Refer to Specification Section 015000 – Temporary Facilities and Controls.



22 August 2023


Changes to Drawings:

1. Sheet E101B – LEVEL 1 PLAN POWER & SPECIAL SYSTEMS NEW WORK

REVISE Keynote #2 added to clarify scope of data cabling requirements for security cameras provided and installed by Owner's vendor.

END OF ADDENDUM 02

P:\114_FLENAME: Autodesk Docs\Perryville Branch Library\MEP_BKM_22240.01_Perryville Branch Library.rvt
 PLOTTING DATE & TIME: 02/22/23 11:46:40 AM

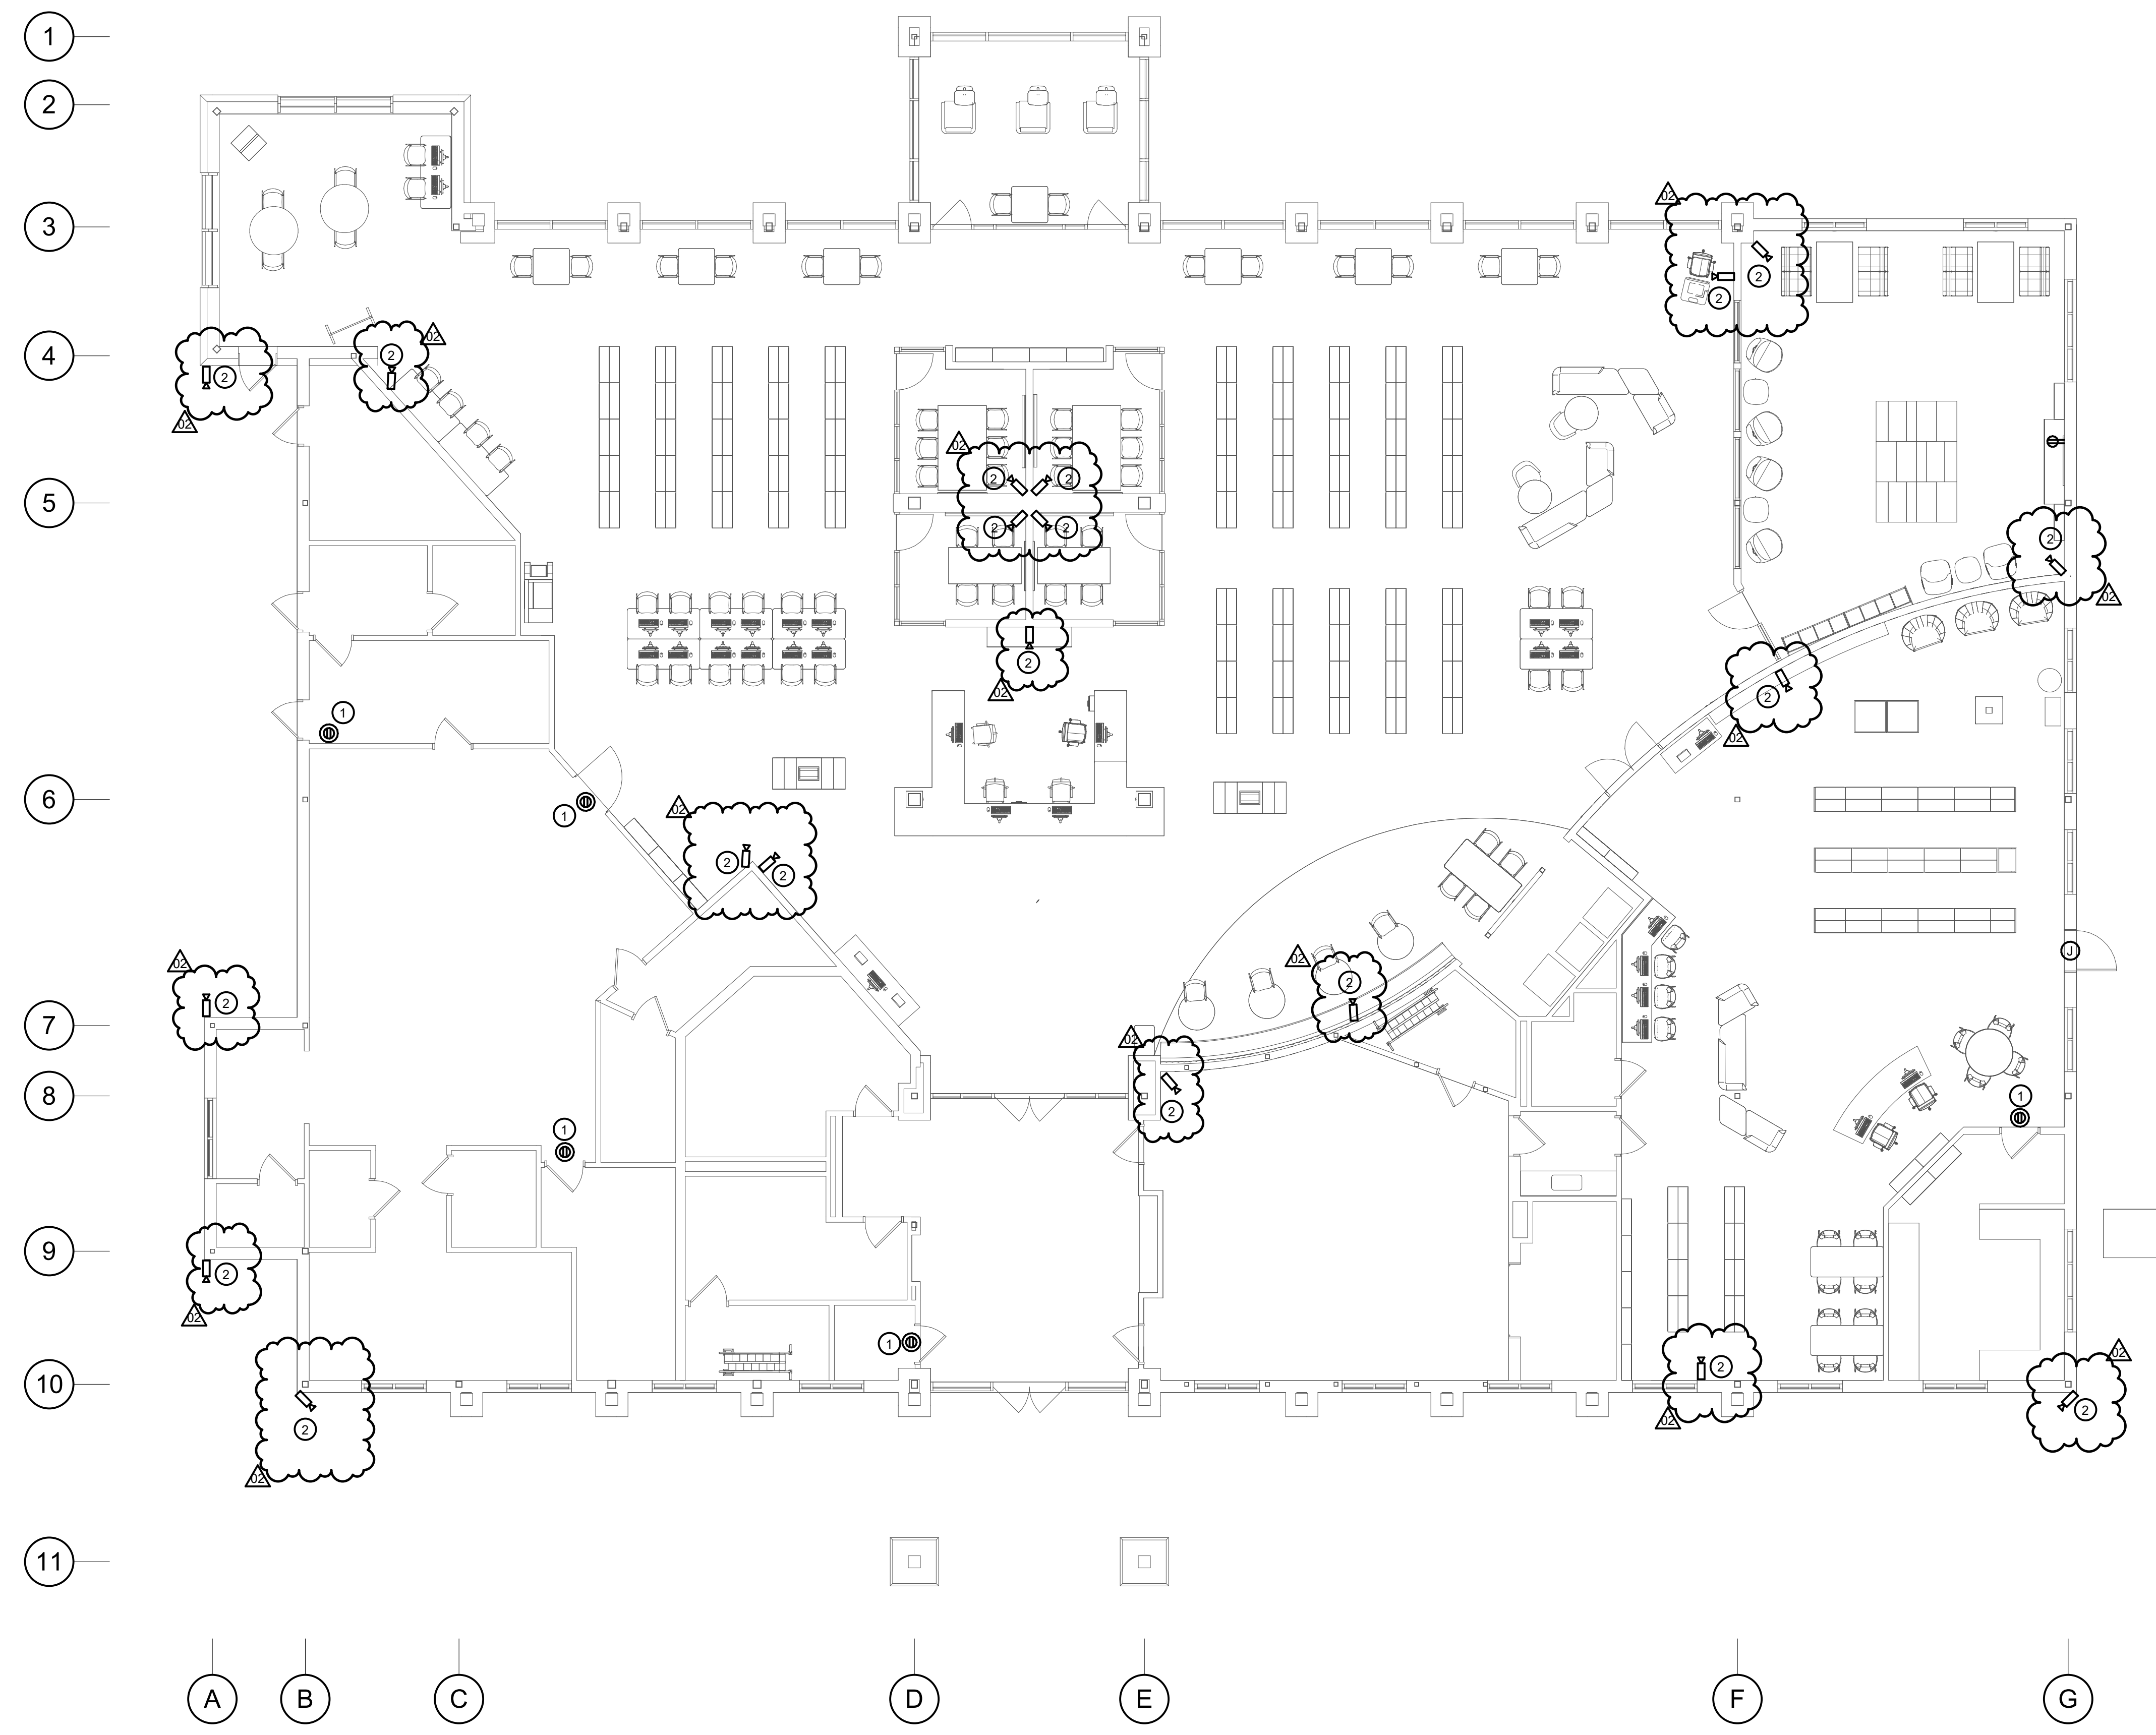

1 LEVEL 1 PLAN - SECURITY SYSTEMS - NEW WORK
 SCALE: 1/8" = 1'-0"

GENERAL NOTES:

- REFER TO E001 FOR ELECTRICAL LEGEND, ABBREVIATIONS AND GENERAL NOTES.
- UNLESS NOTED OTHERWISE, ELECTRICAL ITEMS SHOWN DASHED (---) SHALL BE REMOVED, ELECTRICAL ITEMS SHOWN HEAVY SOLID (—) SHALL BE NEW AND ELECTRICAL ITEMS SHOWN LIGHT SOLID (—) SHALL BE EXISTING TO REMAIN.

DRAWING NOTES:

- DUPLEX RECEPTACLE ABOVE ACCESSIBLE CEILING FOR ACCESS CONTROL'S POWER PROVIDED BY E-C.
- OWNER PROVIDED AND INSTALLED SECURITY CAMERA. PROVIDE CATEGORY 6A CABLE HOMERUN BACK TO NEAREST SERVER ROOM AND TERMINATE ON PATCH PANEL. CABLE SHALL HAVE 10' SERVICE LOOPS COILED UP AT EACH END WITH A TOTAL CABLE LENGTH NOT TO EXCEED 295'.

LVL1 ROOM LIST NEW	
102	JANITOR
103	LOBBY
104	MEETING ROOM
105	STORAGE
106	PANTRY
107	FAMILY TOILET
108	STORAGE
109	CHILDREN'S COLLECTION
110	CHILDREN'S WORKROOM
111	WOMENS
112	SPRINKLER ROOM
113	MENS
114	BRANCH MAN. OFFICE
115	STAFF BREAKROOM
116	STAFF TOILET
117	STORAGE
118	BOOK DROP
119	DRIVE THRU
120	CIRCULATION WORKROOM
121	BOOK DROP
122	SECURE STORAGE
123	DELIVERY ROOM
124	ELECTRICAL ROOM
125	MECHANICAL ROOM
126	SERVER ROOM
127	READING ROOM
128	CIRCULATION & REFERENCE DESKS
129	CAFE
130	FAMILY GATHERING
130	PERIODICALS
131	VENDING
132	TEENS
133	STUDY ROOM
134	STUDY ROOM
135	STUDY ROOM
136	STUDY ROOM
137	CAREER & BUSINESS CENTER
138	QUIET READING



1840 WEST BROAD STREET
 SUITE 400
 RICHMOND, VA 23220
 v 804.788.4774

QUINNEVANS.COM

consultant logo goes here:



Burdette, Koehler, Murphy & Assoc., Inc.
 Mechanical / Electrical Engineers
 6300 Blair Hill Lane, Suite 400
 Baltimore, Maryland 21209
 P: 410.323.0600 | www.bkma.com



"I certify that these documents were prepared or approved by me, and that I am a duly licensed engineer under the laws of the State of Maryland, License No. 20513, Expiration Date 07/17/24.

client logo goes here:

PERRYVILLE BRANCH LIBRARY RENOVATION

CECIL COUNTY PUBLIC LIBRARY

500 COUDON BLVD
 PERRYVILLE, MD 21903

No.	Date	Addendum
02	08/22/23	Addendum 02

PROJECT MANAGER: JMW
 DRAWN BY: TAN

QEA No. 42137020
 100% CONSTRUCTION DOCUMENTS
 08/01/23

**LEVEL 1 PLAN
 POWER & SPECIAL SYSTEMS
 NEW WORK**

E101B

BKM#22240.01

